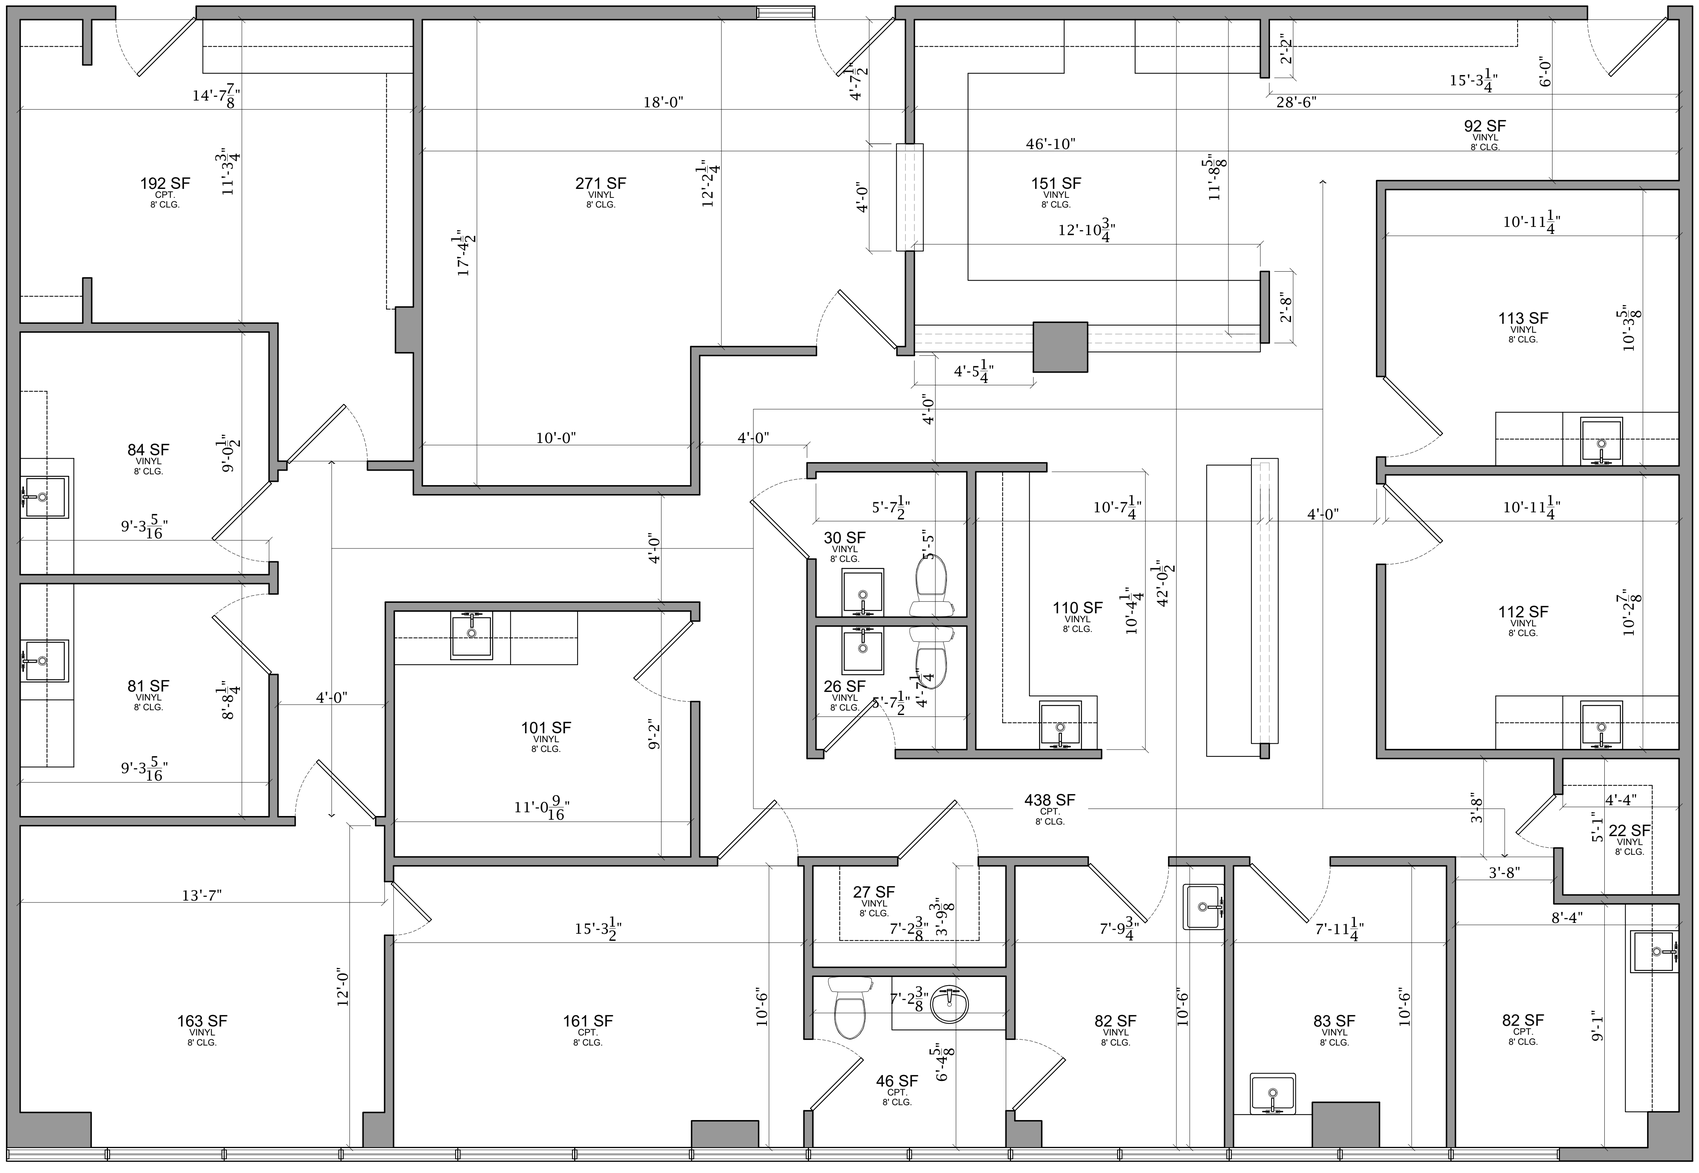

1 FLOOR PLAN
(AS BUILT) 2,615 SF

0 1 2 4 8 16
SCALE : 3/8" = 1'-0"

IDC
IMAGINE DESIGN CONSTRUCT
P : 210.966.7950
E : IMAGINEDESIGNCONSTRUCT@GMAIL.COM
WWW.IMAGINEDESIGNCONSTRUCT.COM

IMAGINE DESIGN CONSTRUCT LLC.
DESIGN DRAWINGS AND SPECS AS INSTRUMENTS OF SERVICE ARE AND SHALL REMAIN EXCLUSIVE PROPERTY OF THE DESIGNER WHETHER THE PROJECT FOR WHICH THEY ARE MADE IS TO BE EXECUTED OR NOT AND SHALL BE RETURNED TO HIM/HER UPON THE COMPLETION OF THE CONSTRUCTION WORK. THEY ARE NOT TO BE USED BY THE OWNER ON THEIR PROJECTS OR EXTENSIONS TO THIS PROJECT EXCEPT BY AGREEMENT IN WRITING FROM THE DESIGNER. ANY CHANGES MADE OUTSIDE THE SCOPE OF WORK AND/ OR AFTER THE APPROVAL OF THE CITY WILL BE THE SOLE RESPONSIBILITY OF THE CLIENT

JOB NAME
MEDICAL OFFICE
CONDO IN CHRISTUS
1305 WONDER WORLD DR
STE. 206
SAN MARCOS, TX 78666

REV	DATE	DESCRIPTION	APP
1	09-16-21	LAYOUT REVIEW	JL

PROJECT NO.	118
DESIGNED BY	IDC - JL
CHECKED BY	IDC - JL

SHEET TITLE

COVER SHEET

A1.0